REV	DESCRIPTION	BY	DATE
A	REVISED PER CUST.REQ.;REMOVED APP.STMP;REISSUED AS RECORD	TB	2/15/05
B	REMOVED CENTRILIFT NAME FROM DRAWING RE-ISSUED AS RECORD DRAWING	DWE	4/10/08
C	CHANGED LOGO	ST	11/02/10

	DESCRIPTION
1	LVB 30BIL .625" STUD W/1H SPADE
4	HVB 30BIL .625" STUD W/1H SPADE
5	SPECIAL TAPS BASE ASSEMBLY
7	NP & SN ON TANK
8	TANK
9	COOLING RADIATORS
10	BOLTED HANDHOLE COVER
12	TAPS LIFTING LUGS
13	JACKING PROVISIONS
14	1/2-12 NEMA GRD PAD
15	1 IN PIPE PLUG
40	TAPS COURSE SW. #1
43	TAPS FINE SW. #2
47	PRESS. REL VALVE
50	OIL LEVEL PLUG
51	TAPS D-Y SW. #3
102	JUNCTION BOX

	SPECIAL NOTES
A	
B	
C	
D	
E	

CUSTOMER :	T.A.P.S. INC.
SPEC.	DATED
KVA 260.0 BIL 60 TAPS NONE	
HIGH VOLTAGE	2560
LOW VOLTAGE	480
APPROX. CORE AND COIL WEIGHT	1585
APPROX. TANK AND ACCESS. WEIGHT	682
GAL. OF OIL 136 ; APPROX. WEIGHT	1021
APPROX. TOTAL WEIGHT	3288

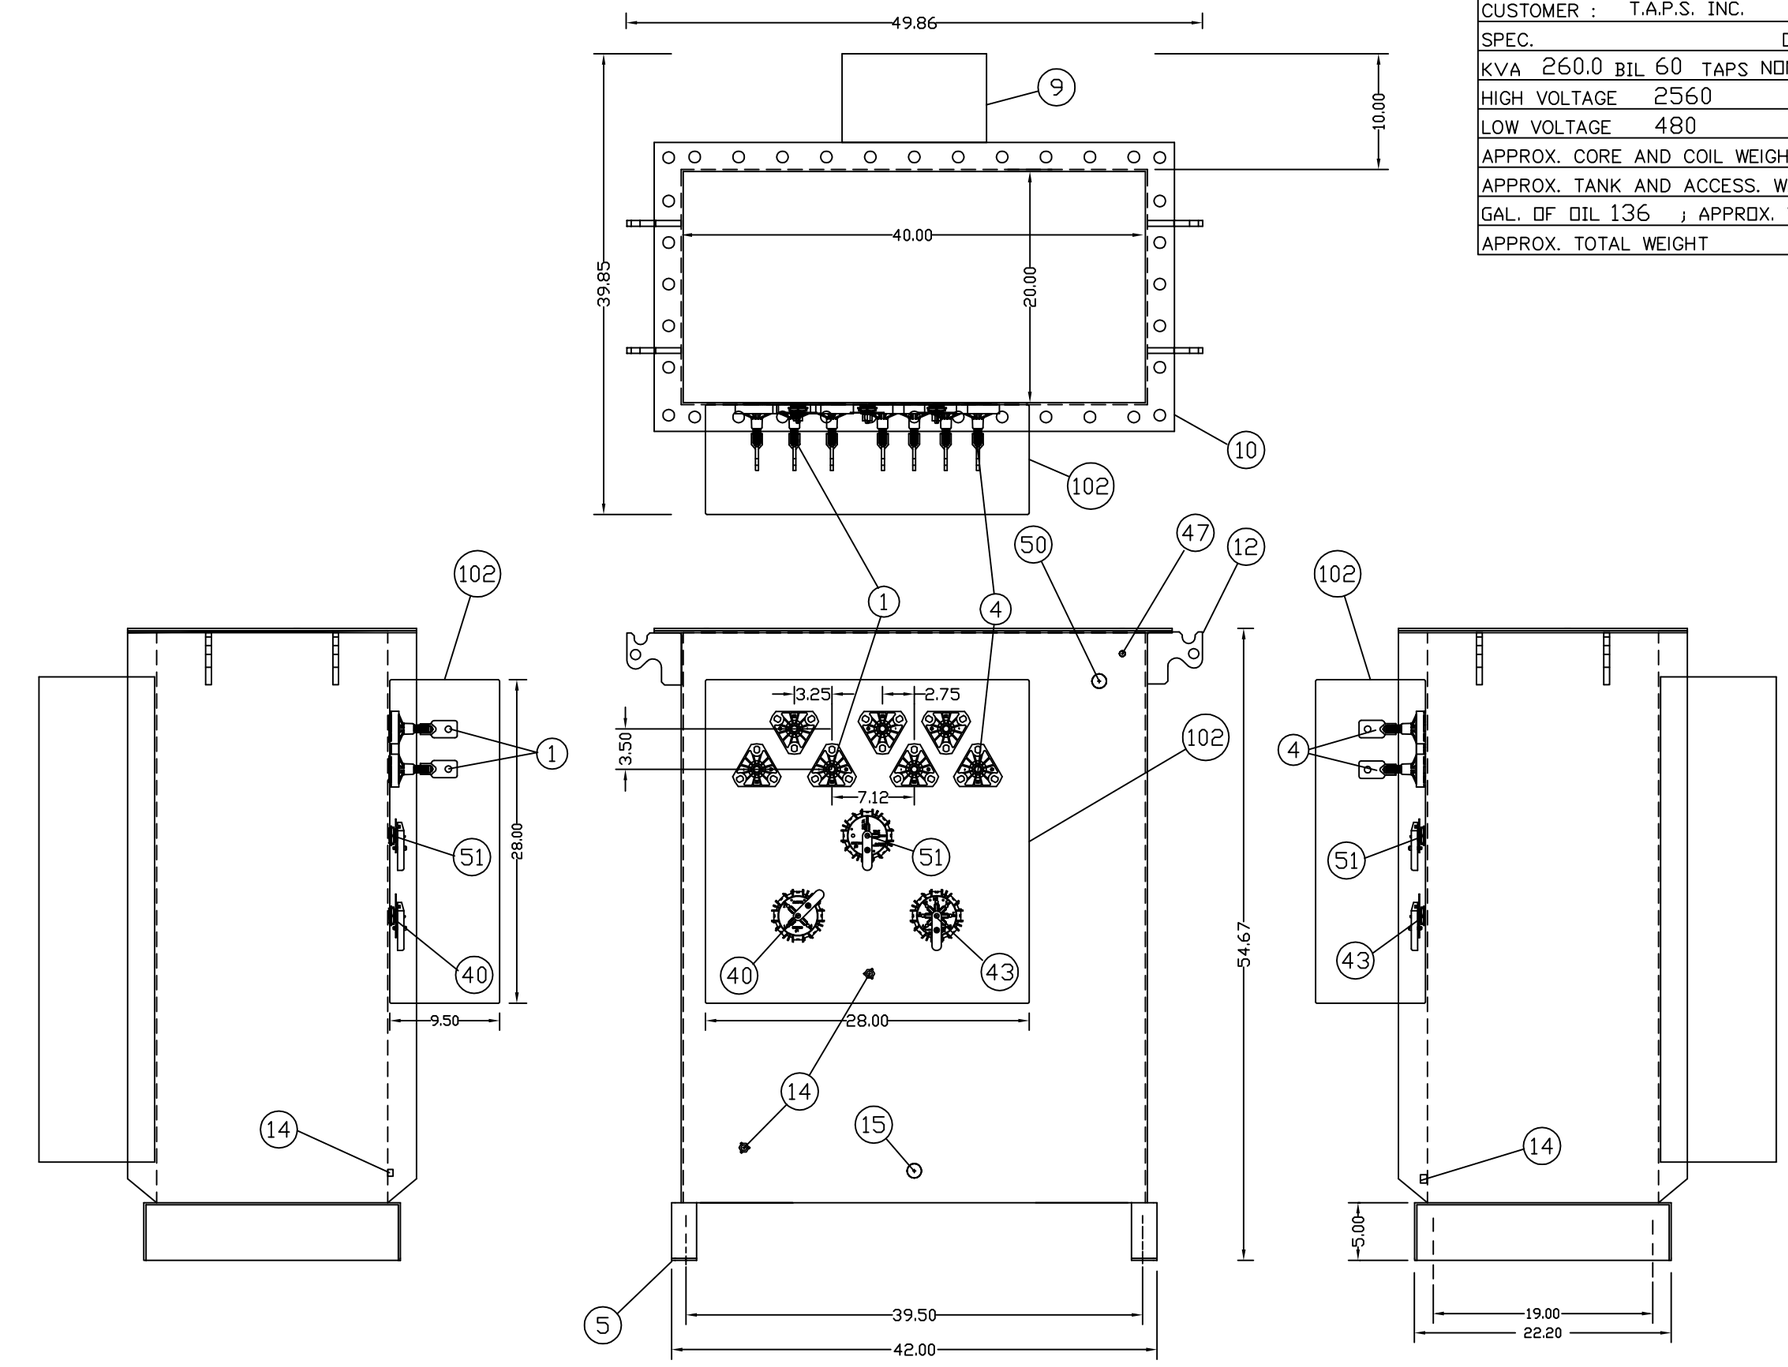

TAPS
MADE IN USA

NAME: OUTLINE DRAWING		CC	745
CAT. NO. 9922410039011			
ID. 3BCB5815	PN. 0073999931.098		
SCALE 0.075	DWG BY TB	CHK BY	DATE: 01/31/05