REV	DESCRIPTION	BY	DATE	REV	DESCRIPTION	BY	DATE	REV	DESCRIPTION	BY	DATE
A	REVISED PER CUSTOMER MARKUPS;REMOVED APP STMP;REISSUED AS RECORD	TB	3/7/05	B	CHANGED LOGO	ST	11/02/10				

	DESCRIPTION
1	
4	HVB 30BIL .625" STUD W/1H SPADE
5	SPL TAPS BASE ASSEMBLY
7	NP'S ON TANK
8	TANK
9	COOLING RADIATORS
10	BOLTED HANDHOLE COVER
12	SPL TAPS LIFTING LUGS
14	1/2" GRD NUT
15	1 IN PIPE PLUG
40	TAPS COURSE SW. #1
43	TAPS FINE SW. #2
47	PRESS. REL VALVE
50	OIL LEVEL PLUG
51	TAPS D-Y SW. #3
102	JUNCTION BOX

	SPECIAL NOTES
A	
B	
C	
D	
E	

CUSTOMER :	
SPEC.	DATED
KVA 390.0 BIL 60 TAPS NONE	
HIGH VOLTAGE 2560	
LOW VOLTAGE 480	
APPROX. CORE AND COIL WEIGHT	2061
APPROX. TANK AND ACCESS. WEIGHT	1062
GAL. OF OIL 214 ; APPROX. WEIGHT	1606
APPROX. TOTAL WEIGHT	4729

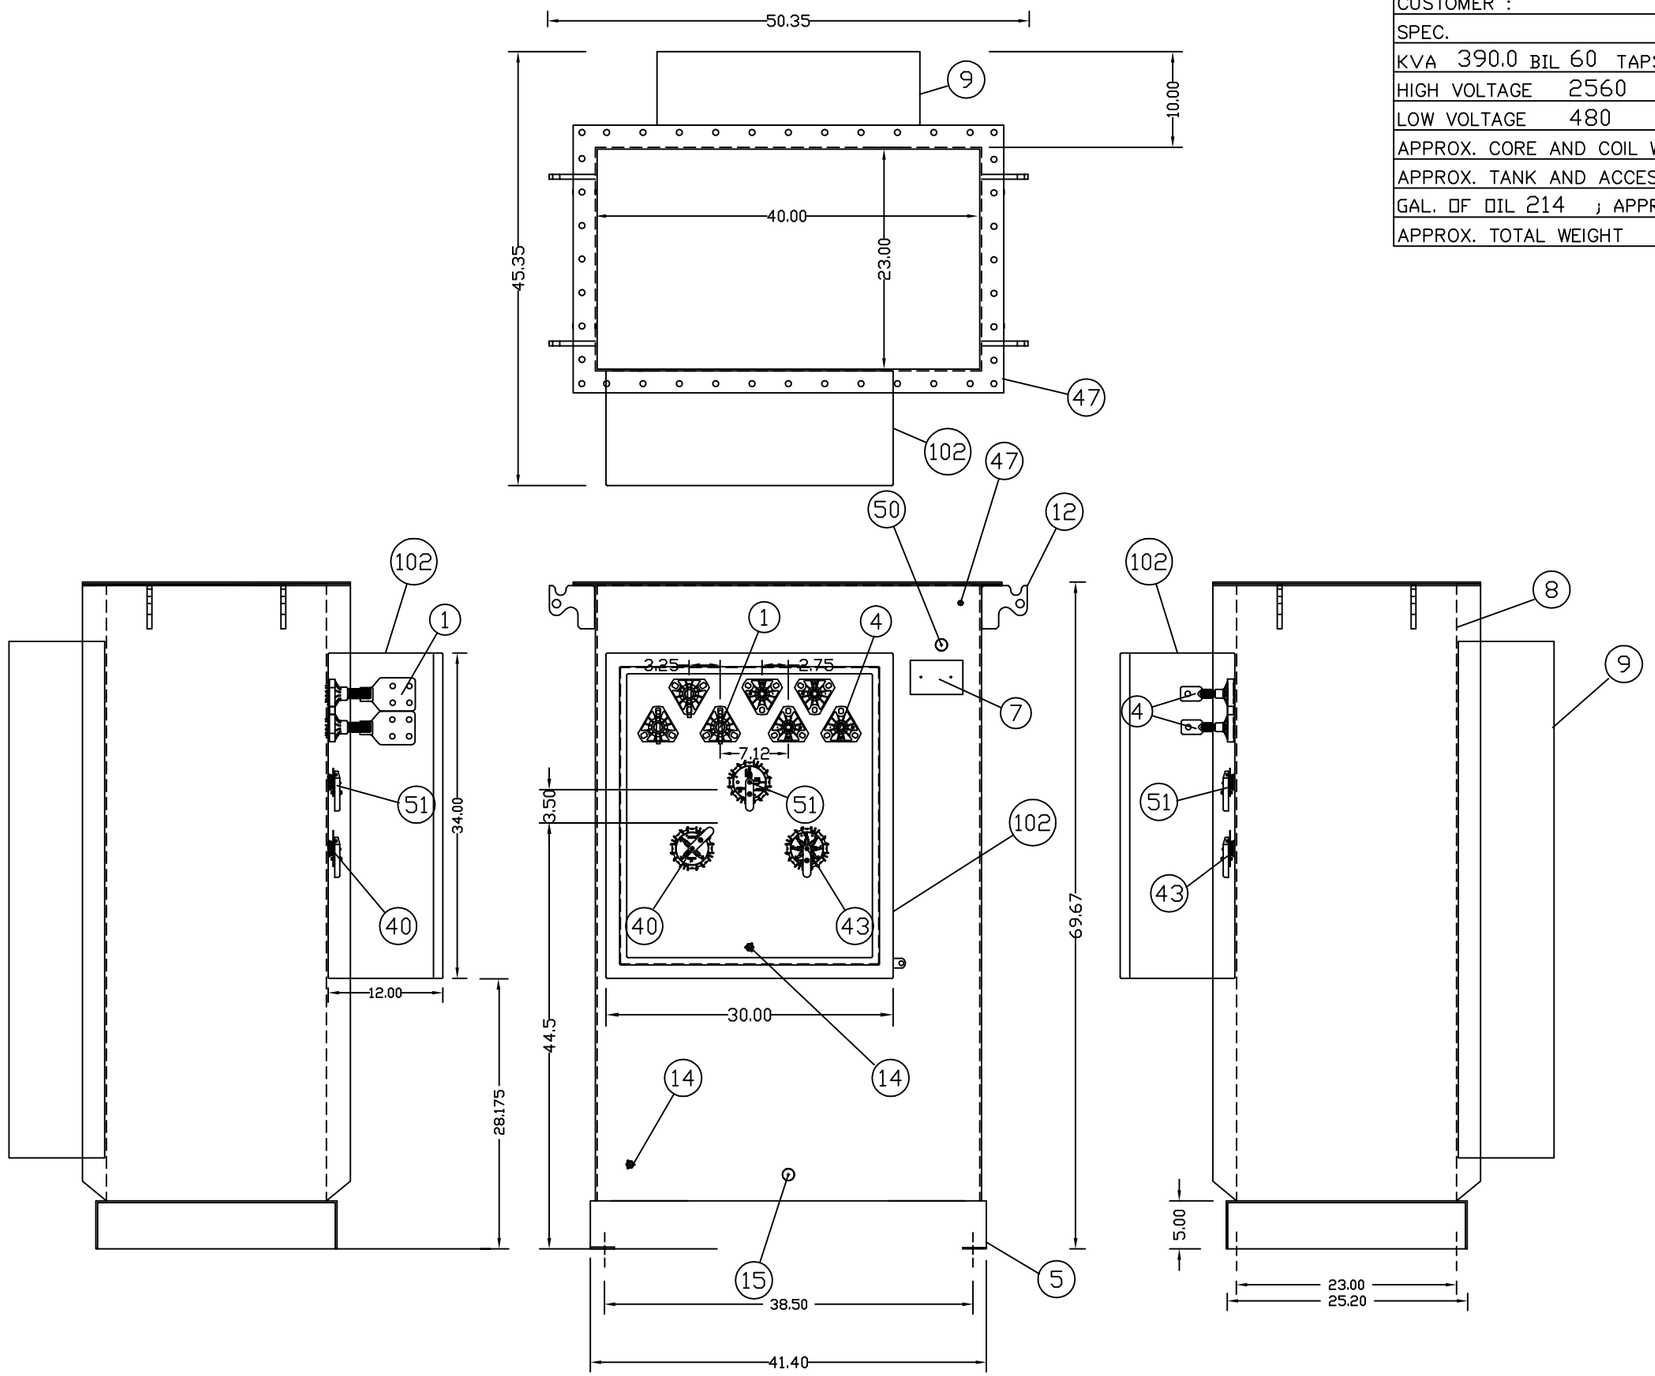

TAPS

MADE IN USA

NAME: CENTRILIFT			CC 745
CAT. NO. 9922410039012			
ID. 3WBT6515		PN. 0073999931.105	
SCALE 0.062	DWG BY TB	CHK BY	DATE: 02/16/05